



PRELIMINARY

DEVELOPMENT APPLICATION

ARCHITECT: PLACE STUDIO
11500 FERRIS AVENUE | BIRMGHAM, ALABAMA 35244
TEL: 205.988.1100 | WWW.PLACESTUDIO.COM

DRAWING TITLE: BASEMENT 2
PROJECT: #2024048 ORCHARD TERRACE STAGE 02
SUBMITTED TO: 5/15/2024
CLIENT: BLAG PROJECTS

SHEET NUMBER: SK2-02
REV: F
DATE: 5/24/2024

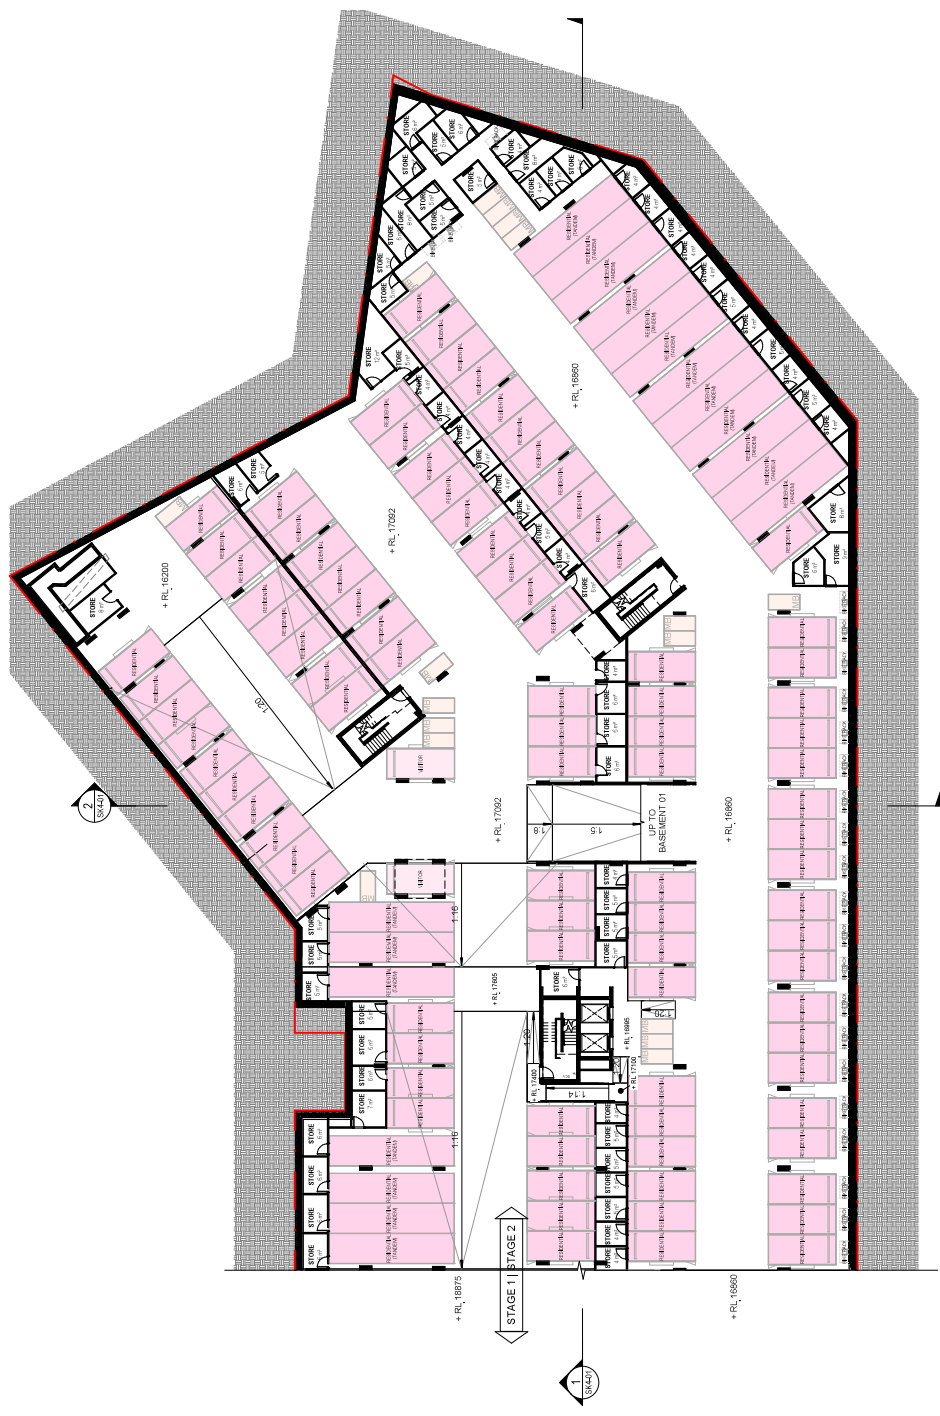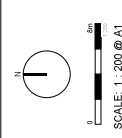

LEGEND:


[Pink Box]	RESIDENTIAL
[Light Blue Box]	RESIDENTIAL VISITOR
[Light Green Box]	COMMERCIAL
[Light Orange Box]	COMMERCIAL STAFF
[Light Purple Box]	HOSPITAL STAFF
[Light Yellow Box]	HOSPITAL VISITOR
[Light Cyan Box]	HOSPITAL VISITOR GROUP OFF
[Light Red Box]	MOTORBIKE

REVISION:

REV	DATE	DESCRIPTION
A	24.05.2024	ISSUE FOR REVIEW
B	24.06.2024	ISSUE FOR REVIEW
C	24.07.2024	ISSUE FOR INFORMATION
D	23.08.2024	ISSUE FOR INFORMATION
E	14.09.2024	NO APPLICATION
F	23.10.2024	ISSUE FOR INFORMATION

NOTES:
1. ALL DIMENSIONS ARE TO FACE UNLESS OTHERWISE SPECIFIED.
2. ALL WALLS ARE 120mm THICK UNLESS OTHERWISE SPECIFIED.
3. ALL FLOORS ARE TO BE FINISHED TO THE TOP OF THE FINISH FLOOR LEVEL.
4. ALL CEILING ARE TO BE FINISHED TO THE TOP OF THE FINISH CEILING LEVEL.
5. ALL SERVICES ARE TO BE INSTALLED IN ACCORDANCE WITH THE RELEVANT STANDARDS AND REGULATIONS.
6. ALL SERVICES ARE TO BE INSTALLED IN ACCORDANCE WITH THE RELEVANT STANDARDS AND REGULATIONS.
7. ALL SERVICES ARE TO BE INSTALLED IN ACCORDANCE WITH THE RELEVANT STANDARDS AND REGULATIONS.
8. ALL SERVICES ARE TO BE INSTALLED IN ACCORDANCE WITH THE RELEVANT STANDARDS AND REGULATIONS.
9. ALL SERVICES ARE TO BE INSTALLED IN ACCORDANCE WITH THE RELEVANT STANDARDS AND REGULATIONS.
10. ALL SERVICES ARE TO BE INSTALLED IN ACCORDANCE WITH THE RELEVANT STANDARDS AND REGULATIONS.


NLA = 3481SQM

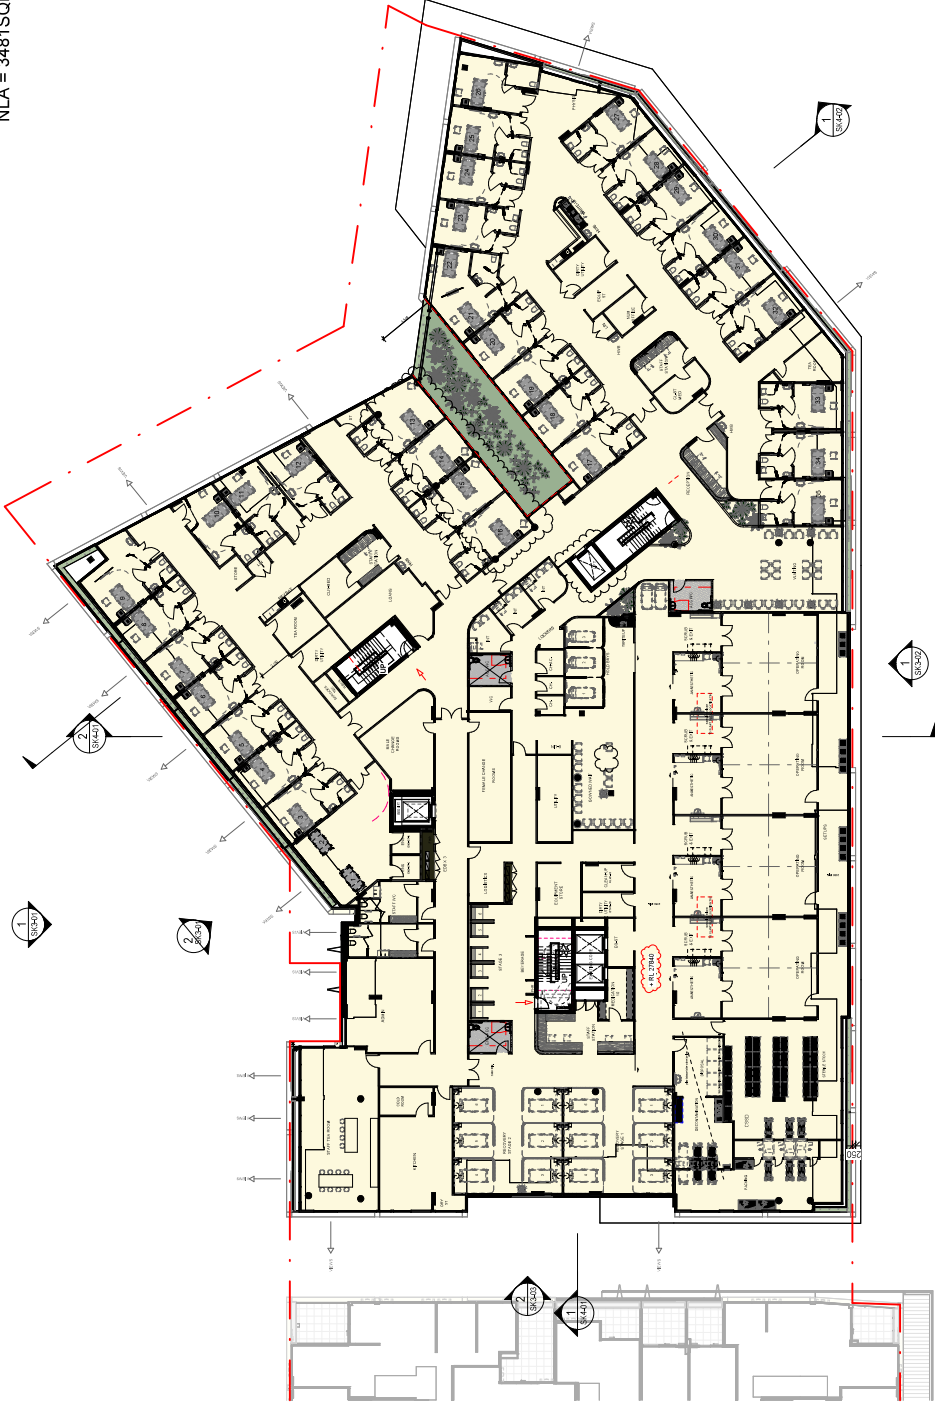

NOTES:
 1. All dimensions are in millimeters unless otherwise stated.
 2. All dimensions are to the centerline of walls and columns unless otherwise stated.
 3. All dimensions are to the centerline of doors and windows unless otherwise stated.
 4. All dimensions are to the centerline of stairs and ramps unless otherwise stated.
 5. All dimensions are to the centerline of balconies and terraces unless otherwise stated.
 6. All dimensions are to the centerline of parking spaces unless otherwise stated.
 7. All dimensions are to the centerline of setbacks unless otherwise stated.
 8. All dimensions are to the centerline of setbacks unless otherwise stated.
 9. All dimensions are to the centerline of setbacks unless otherwise stated.
 10. All dimensions are to the centerline of setbacks unless otherwise stated.

REV	DATE	DESCRIPTION
A	24.02.2024	ISSUE FOR REVIEW
B	24.02.2024	ISSUE FOR REVIEW
C	24.02.2024	ISSUE FOR REVIEW
D	24.02.2024	ISSUE FOR REVIEW
E	14.02.2024	ISSUE FOR REVIEW
F	14.02.2024	ISSUE FOR REVIEW
G	14.02.2024	ISSUE FOR REVIEW

LEGEND:
 1. STAIR
 2. STAIR
 3. STAIR
 4. STAIR
 5. STAIR

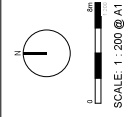


PROJECT:
 #2024048
ORCHARD TERRACE STAGE 02
 5 WATSONIA AVENUE
 SUBURBIO VIC 3008
 CLIENT: BLAGO PROJECTS

DRAWING TITLE:
LEVEL 1 PLAN
 SHEET NUMBER:
SK2-05
 DATE: 19/02/2025

ARCHITECT:
PLACE
 STUDIO
 LEVEL 10, 100 WATSONIA AVENUE, SUBURBIO VIC 3008
 PH: 03 9439 1234
 WWW.PLACESTUDIO.COM.AU
 REV: **G**

DEVELOPMENT APPLICATION

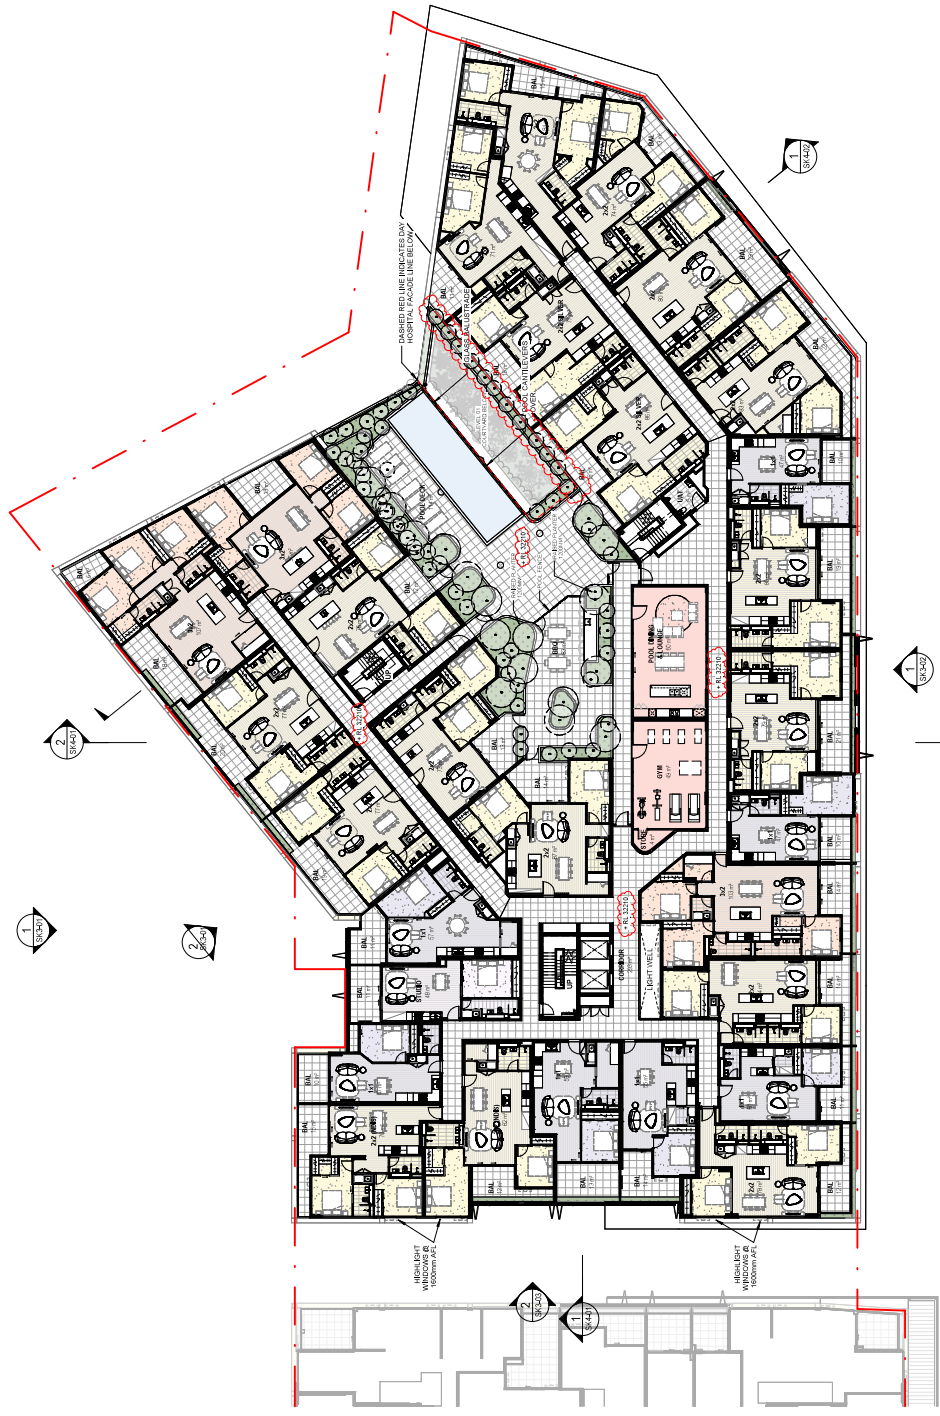


DEVELOPMENT APPLICATION

ARCHITECT:
PLACE
 STUDIO
 1000 WESTERN AVENUE | PHOENIX, AZ 85009

DRAWING TITLE:
LEVEL 2 PLAN
 SHEET NUMBER:
SK2-07
 REV: **G**
 DATE: 11/06/2025


PROJECT:
 #2024048
ORCHARD TERRACE STAGE 02
 5 W. WILSON AVENUE
 SUBDIVISION: 10000
 CLIENT: BLAQ PROJECTS

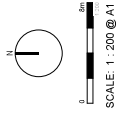

LEGEND:

REV	DATE	DESCRIPTION
A	24.02.2024	ISSUE FOR REVIEW
B	24.02.2024	ISSUE FOR REVIEW
C	24.02.2024	ISSUE FOR REVIEW
D	24.02.2024	ISSUE FOR REVIEW
E	14.02.2024	ISSUE FOR REVIEW
F	14.02.2024	ISSUE FOR REVIEW
G	14.02.2024	ISSUE FOR REVIEW

11/06/2025 14:27:39
 ALL RIGHTS RESERVED. THIS DOCUMENT IS THE PROPERTY OF PLACE ARCHITECTURE. NO PART OF THIS DOCUMENT MAY BE REPRODUCED OR TRANSMITTED IN ANY FORM OR BY ANY MEANS, ELECTRONIC OR MECHANICAL, WITHOUT THE WRITTEN PERMISSION OF PLACE ARCHITECTURE. PLACE ARCHITECTURE IS NOT RESPONSIBLE FOR ANY ERRORS OR OMISSIONS IN THIS DOCUMENT. THE USER OF THIS DOCUMENT IS ADVISED THAT THE INFORMATION CONTAINED HEREIN IS UNCLASSIFIED AND NOT FOR OFFICIAL USE ONLY. PLACE ARCHITECTURE IS NOT A REGISTERED ARCHITECT IN THE STATE OF ARIZONA. PLACE ARCHITECTURE IS NOT A REGISTERED ARCHITECT IN THE STATE OF CALIFORNIA. PLACE ARCHITECTURE IS NOT A REGISTERED ARCHITECT IN THE STATE OF FLORIDA. PLACE ARCHITECTURE IS NOT A REGISTERED ARCHITECT IN THE STATE OF GEORGIA. PLACE ARCHITECTURE IS NOT A REGISTERED ARCHITECT IN THE STATE OF ILLINOIS. PLACE ARCHITECTURE IS NOT A REGISTERED ARCHITECT IN THE STATE OF INDIANA. PLACE ARCHITECTURE IS NOT A REGISTERED ARCHITECT IN THE STATE OF IOWA. PLACE ARCHITECTURE IS NOT A REGISTERED ARCHITECT IN THE STATE OF KANSAS. PLACE ARCHITECTURE IS NOT A REGISTERED ARCHITECT IN THE STATE OF KENTUCKY. PLACE ARCHITECTURE IS NOT A REGISTERED ARCHITECT IN THE STATE OF LOUISIANA. PLACE ARCHITECTURE IS NOT A REGISTERED ARCHITECT IN THE STATE OF MARYLAND. PLACE ARCHITECTURE IS NOT A REGISTERED ARCHITECT IN THE STATE OF MASSACHUSETTS. PLACE ARCHITECTURE IS NOT A REGISTERED ARCHITECT IN THE STATE OF MICHIGAN. PLACE ARCHITECTURE IS NOT A REGISTERED ARCHITECT IN THE STATE OF MINNESOTA. PLACE ARCHITECTURE IS NOT A REGISTERED ARCHITECT IN THE STATE OF MISSISSIPPI. PLACE ARCHITECTURE DEVELOPMENT APPLICATION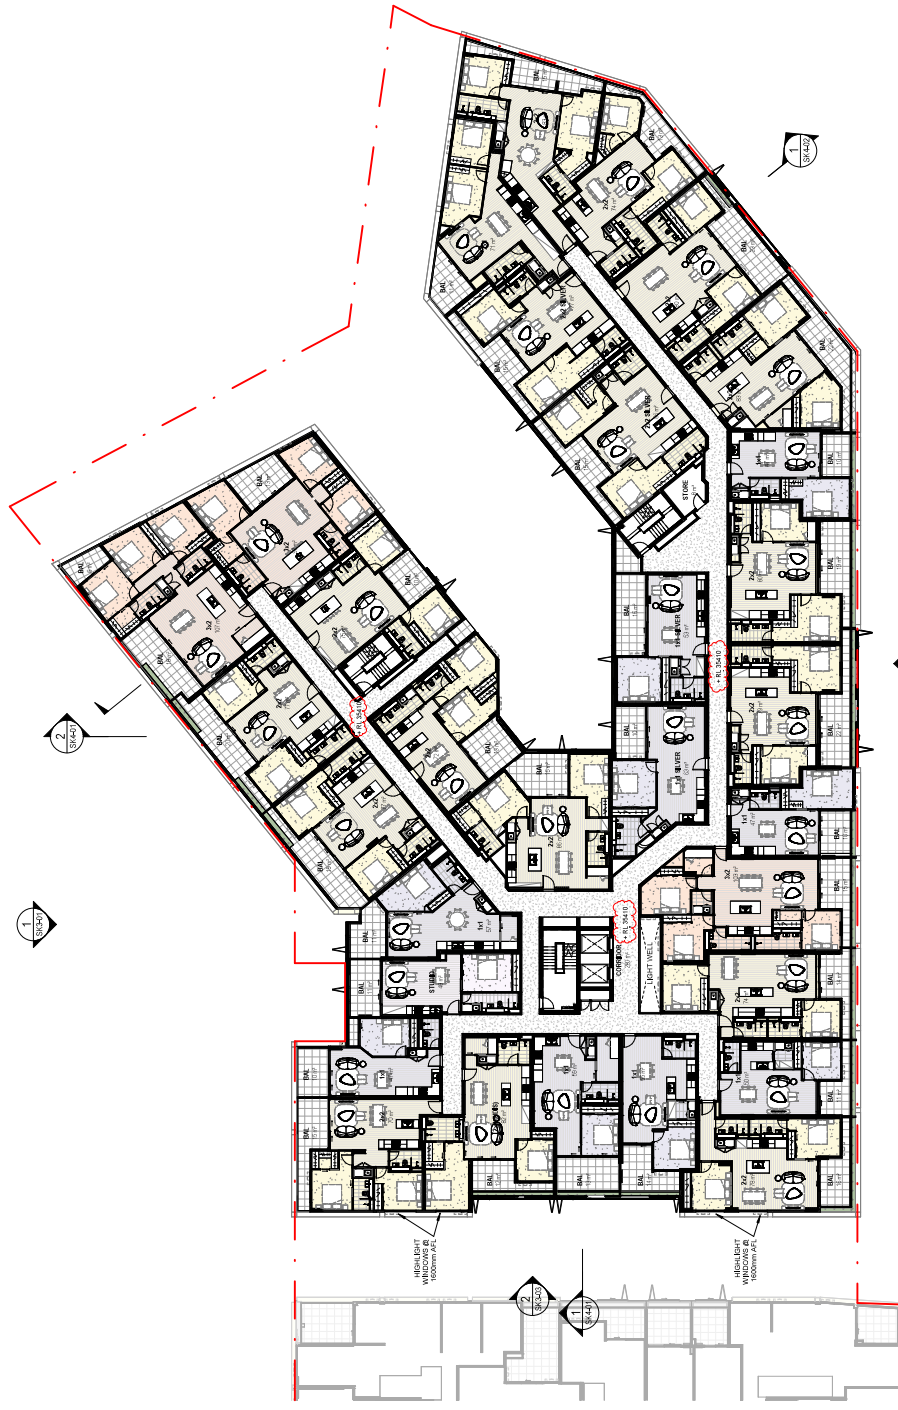

ARCHITECT:
PLACE
 STUDIO
 5 WATERLOO PL. #1404
 TORONTO, ONTARIO M5S 0A5
 TEL: 416-977-8888
 WWW.PLACESTUDIO.COM

DRAWING TITLE:
LEVEL 3 PLAN


SHEET NUMBER:
SK2-08

REV:
G

DATE: 15/06/2025

PROJECT:
 #2024048
ORCHARD TERRACE STAGE 02
 5 WATERLOO PL. #1404
 TORONTO, ONTARIO M5S 0A5


CLIENT: BLAQ PROJECTS

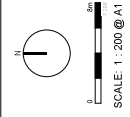

LEGEND:

REV	DATE	DESCRIPTION
A	24.06.2024	ISSUE FOR REVIEW
B	24.06.2024	ISSUE FOR REVIEW
C	24.06.2024	ISSUE FOR REVIEW
D	02.09.2024	ISSUE FOR INFORMATION
E	14.09.2024	FOR APPLICATION
F	15.09.2024	FOR APPLICATION
G	15.09.2025	FOR APPLICATION

15/06/2025 14:45:19
 This drawing is the property of PLACE STUDIO. It is to be used only for the project and site for which it is prepared. It is not to be used for any other project or site without the written consent of PLACE STUDIO. PLACE STUDIO shall not be held responsible for any errors or omissions in this drawing. PLACE STUDIO shall not be held responsible for any delays or cancellations of this project. PLACE STUDIO shall not be held responsible for any changes or modifications to this drawing. PLACE STUDIO shall not be held responsible for any costs or expenses incurred by the client in connection with this project. PLACE STUDIO shall not be held responsible for any damages or losses suffered by the client in connection with this project. PLACE STUDIO shall not be held responsible for any claims or actions against the client in connection with this project. PLACE STUDIO shall not be held responsible for any claims or actions against PLACE STUDIO in connection with this project.

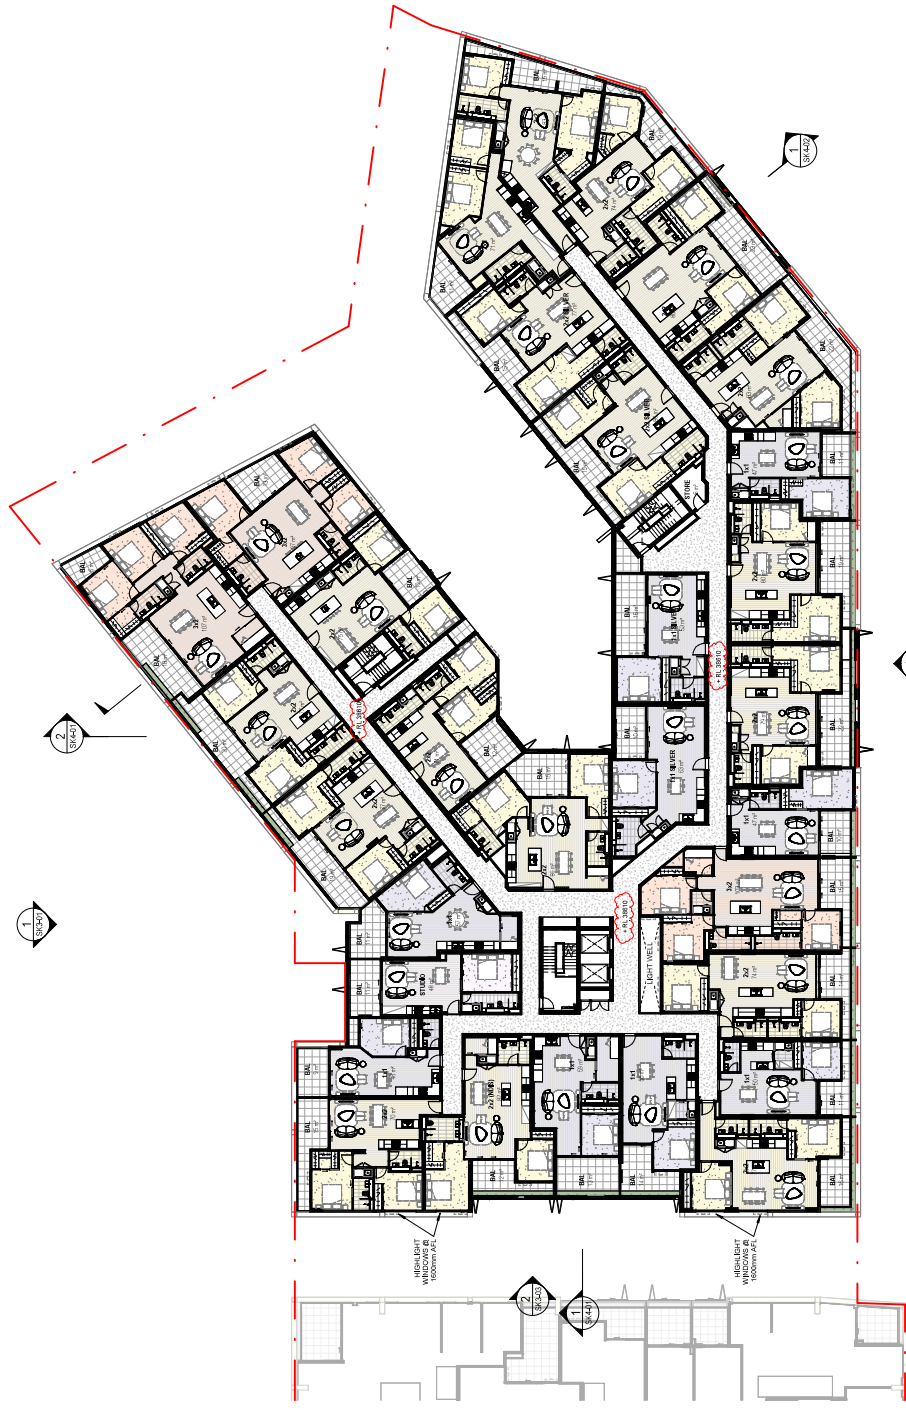

1. All drawings are the property of PLACÉ ARCHITECT and shall remain their property. 2. No part of this drawing may be reproduced, stored in a retrieval system, or transmitted in any form or by any means, electronic, mechanical, photocopying, recording, or by any information storage and retrieval system, without the prior written permission of PLACÉ ARCHITECT. 3. This drawing is intended for the use of the client and is not to be used for any other purpose. 4. The client is responsible for obtaining all necessary permits and approvals. 5. The architect is not responsible for any errors or omissions in this drawing. 6. The architect is not responsible for any construction or other work done in reliance on this drawing. 7. The architect is not responsible for any damage or injury to persons or property resulting from the use of this drawing. 8. The architect is not responsible for any delay or interruption of work resulting from the use of this drawing. 9. The architect is not responsible for any cost or expense incurred by the client in reliance on this drawing. 10. The architect is not responsible for any liability of any kind incurred by the client in reliance on this drawing.

REV	DATE	DESCRIPTION
A	24.02.2024	ISSUE FOR REVIEW
B	24.02.2024	ISSUE FOR REVIEW
C	24.02.2024	ISSUE FOR REVIEW
D	24.02.2024	ISSUE FOR REVIEW
E	14.02.2024	ISSUE FOR REVIEW
F	14.02.2024	ISSUE FOR REVIEW
G	14.02.2024	ISSUE FOR REVIEW

LEGEND:


PROJECT:
#2024048
ORCHARD TERRACE STAGE 02
SUBMITTED BY: PLACÉ ARCHITECT
SUBMITTED ON: 08/08/2023
CLIENT: BLAQ PROJECTS


DRAWING TITLE:
LEVEL 4 PLAN

SHEET NUMBER:
SK2-09

ARCHITECT:
PLACÉ ARCHITECT
S T U D I O
L I M I T E D
Level 45, 100 Victoria Street, Melbourne, VIC 3000
111 Frome Street, Melbourne VIC 3000
P 03 9493 8900
E info@placearchitect.com.au
W www.placearchitect.com.au

DATE: 19/08/2023
REV: G

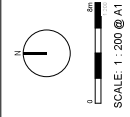

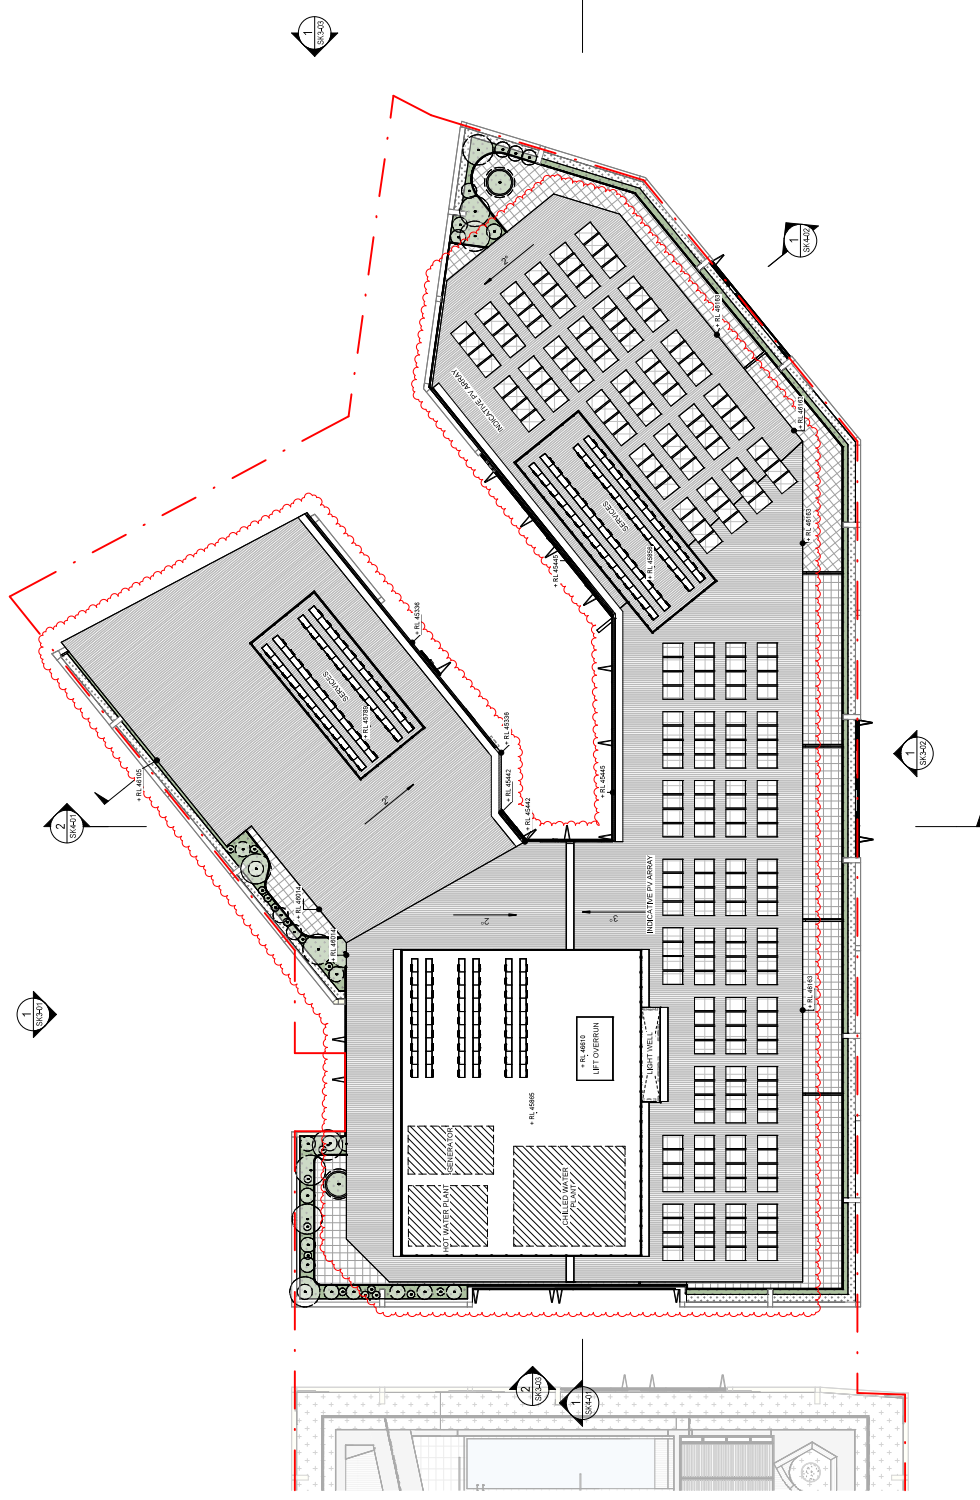

DEVELOPMENT APPLICATION

ARCHITECT: **PLACE**
 STUDIO
 5110 UNIVERSITY AVENUE
 SUITE 100
 VANCOUVER, BC V6L 2K6
 TEL: 604.275.1111
 WWW.PLACESTUDIO.COM

DRAWING TITLE: **ROOF PLAN**


SHEET NUMBER: **SK2-11**

REV: **G**

DATE: 20/06/2025

PROJECT: **#2024048**
ORCHARD TERRACE STAGE 02
 5110 UNIVERSITY AVENUE
 SUBDIVISION 1000

CLIENT: **BLAQ PROJECTS**

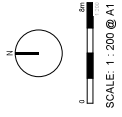


LEGEND:

REV	DATE	DESCRIPTION
A	20.06.2024	ISSUE FOR REVIEW
B	26.06.2024	ISSUE FOR REVIEW
C	02.07.2024	ISSUE FOR REVIEW
D	02.07.2024	ISSUE FOR SUBMITTAL
E	14.08.2024	FOR APPLICATION
F	14.08.2024	FOR APPLICATION
G	20.06.2025	FOR APPLICATION

NOTES:
 1. ALL DIMENSIONS ARE TO FACE UNLESS OTHERWISE SPECIFIED.
 2. REFER TO THE ARCHITECTURAL DRAWINGS FOR MATERIALS AND FINISHES.
 3. REFER TO THE STRUCTURAL DRAWINGS FOR COLUMN AND BEAM LOCATIONS.
 4. REFER TO THE MECHANICAL DRAWINGS FOR EQUIPMENT LOCATIONS.
 5. REFER TO THE ELECTRICAL DRAWINGS FOR PANEL AND CONDUIT LOCATIONS.
 6. REFER TO THE CIVIL DRAWINGS FOR SITE ELEVATIONS AND DRAINAGE.
 7. REFER TO THE LANDSCAPE ARCHITECTURE DRAWINGS FOR PLANTING AND HARDSCAPE.
 8. REFER TO THE INTERIOR ARCHITECTURE DRAWINGS FOR FLOOR FINISHES AND CEILING HEIGHTS.
 9. REFER TO THE EXTERIOR ARCHITECTURE DRAWINGS FOR CURBS, WALKWAYS, AND RAMPWAYS.
 10. REFER TO THE UTILITY DRAWINGS FOR WATER, SEWER, AND GAS SERVICES.
 11. REFER TO THE TRAFFIC ENGINEERING DRAWINGS FOR DRIVEWAY AND PARKING LAYOUTS.
 12. REFER TO THE ENVIRONMENTAL DRAWINGS FOR SOIL REMEDIATION AND MONITORING.
 13. REFER TO THE HISTORIC PRESERVATION DRAWINGS FOR ARCHITECTURAL DETAILS AND MATERIALS.
 14. REFER TO THE ARCHITECTURAL RECORD DRAWINGS FOR AS-BUILT CONDITIONS.
 15. REFER TO THE ARCHITECTURAL SPECIFICATIONS FOR MATERIALS AND FINISHES.
 16. REFER TO THE ARCHITECTURAL CONTRACT DOCUMENTS FOR TERMS AND CONDITIONS.
 17. REFER TO THE ARCHITECTURAL SCHEDULES FOR EQUIPMENT AND MATERIALS.
 18. REFER TO THE ARCHITECTURAL DRAWINGS FOR THE PROJECT'S LOCATION AND SURROUNDINGS.
 19. REFER TO THE ARCHITECTURAL DRAWINGS FOR THE PROJECT'S DESIGN AND CONSTRUCTION.
 20. REFER TO THE ARCHITECTURAL DRAWINGS FOR THE PROJECT'S OPERATION AND MAINTENANCE.



SOUTH ELEVATION - APPROVED DA
1:200

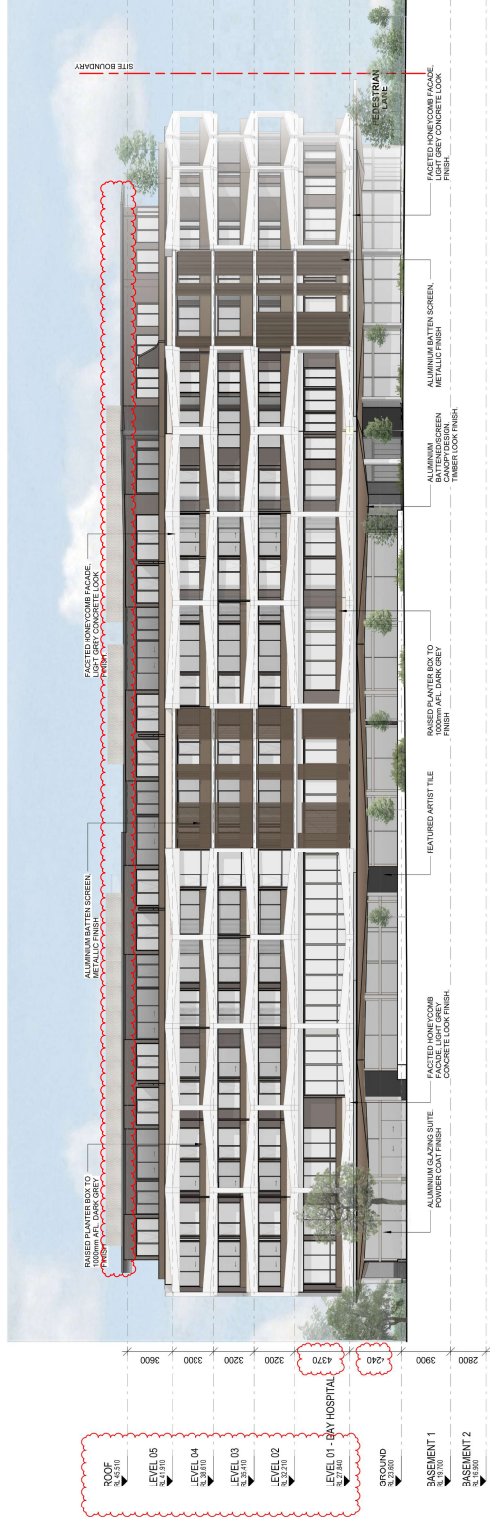

SOUTH ELEVATION - PROPOSED
1:200


REVISION:

REV	DATE	DESCRIPTION
A	24.08.2024	ISSUED FOR REVIEW
B	24.08.2024	ISSUED FOR REVIEW
C	22.09.2024	ISSUED FOR REVIEW
D	02.09.2024	ISSUED FOR REVIEW
E	14.09.2024	DA APPROVAL
F	20.09.2024	DA APPROVAL


LEGEND:

REV	DATE	DESCRIPTION
A	24.08.2024	ISSUED FOR REVIEW
B	24.08.2024	ISSUED FOR REVIEW
C	22.09.2024	ISSUED FOR REVIEW
D	02.09.2024	ISSUED FOR REVIEW
E	14.09.2024	DA APPROVAL
F	20.09.2024	DA APPROVAL

REV	DATE	DESCRIPTION
A	24.08.2024	ISSUED FOR REVIEW
B	24.08.2024	ISSUED FOR REVIEW
C	22.09.2024	ISSUED FOR REVIEW
D	02.09.2024	ISSUED FOR REVIEW
E	14.09.2024	DA APPROVAL
F	20.09.2024	DA APPROVAL

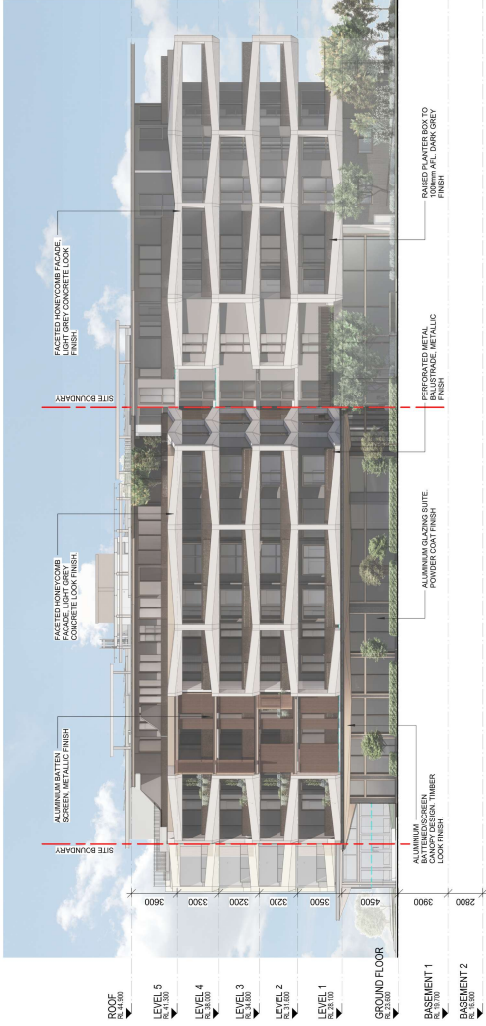

EAST ELEVATION - APPROVED DA
1: 200

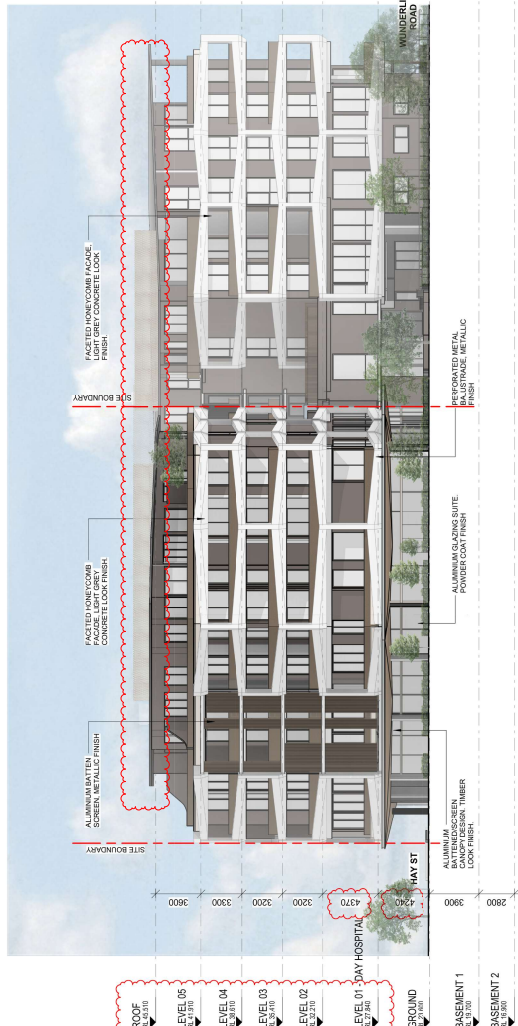

EAST ELEVATION - PROPOSED
1: 200




WEST ELEVATION - PROPOSED
1: 200

NOTES:
1. All elevations are shown in perspective. All dimensions are in millimeters unless otherwise stated.
2. All elevations are shown in perspective. All dimensions are in millimeters unless otherwise stated.
3. All elevations are shown in perspective. All dimensions are in millimeters unless otherwise stated.
4. All elevations are shown in perspective. All dimensions are in millimeters unless otherwise stated.
5. All elevations are shown in perspective. All dimensions are in millimeters unless otherwise stated.
6. All elevations are shown in perspective. All dimensions are in millimeters unless otherwise stated.
7. All elevations are shown in perspective. All dimensions are in millimeters unless otherwise stated.
8. All elevations are shown in perspective. All dimensions are in millimeters unless otherwise stated.
9. All elevations are shown in perspective. All dimensions are in millimeters unless otherwise stated.
10. All elevations are shown in perspective. All dimensions are in millimeters unless otherwise stated.

REVISION:	REV	DATE	DESCRIPTION
	A	20230205	Client Approval

LEGEND:

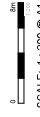

SCALE: 1: 200 @ A1

PROJECT:
#2024048
ORCHARD TERRACE STAGE 02
5 WYNDHAM AVENUE
SUBURB VIC 3088
CLIENT: BIAO PROJECTS

DRAWING TITLE
EAST & WEST ELEVATION

SHEET NUMBER:
SK3-03
DATE: 20/06/2025

REV: A

ARCHITECT:
PLACE
S T U D I O
Level 10, 100 William Street, Melbourne VIC 3000
111 From Melbourne | 03 9419 4000

DEVELOPMENT APPLICATION



SECTION 1
1 : 200



SECTION 2
1 : 200

LEGEND:

REV	DATE	DESCRIPTION
A	24.06.2024	ISSUE FOR REVIEW
B	24.06.2024	ISSUE FOR REVIEW
C	24.06.2024	ISSUE FOR REVIEW
D	02.07.2024	ISSUE FOR REVIEW
E	14.08.2024	ON APPLICATION
F	20.06.2025	ON APPLICATION

NOTES:

1. All dimensions are in millimeters unless otherwise stated.

2. All levels are in Australian Height Datum (AHD) unless otherwise stated.

3. All levels are in meters unless otherwise stated.

4. All levels are in meters unless otherwise stated.

5. All levels are in meters unless otherwise stated.


6. All levels are in meters unless otherwise stated.

7. All levels are in meters unless otherwise stated.

8. All levels are in meters unless otherwise stated.

9. All levels are in meters unless otherwise stated.

10. All levels are in meters unless otherwise stated.

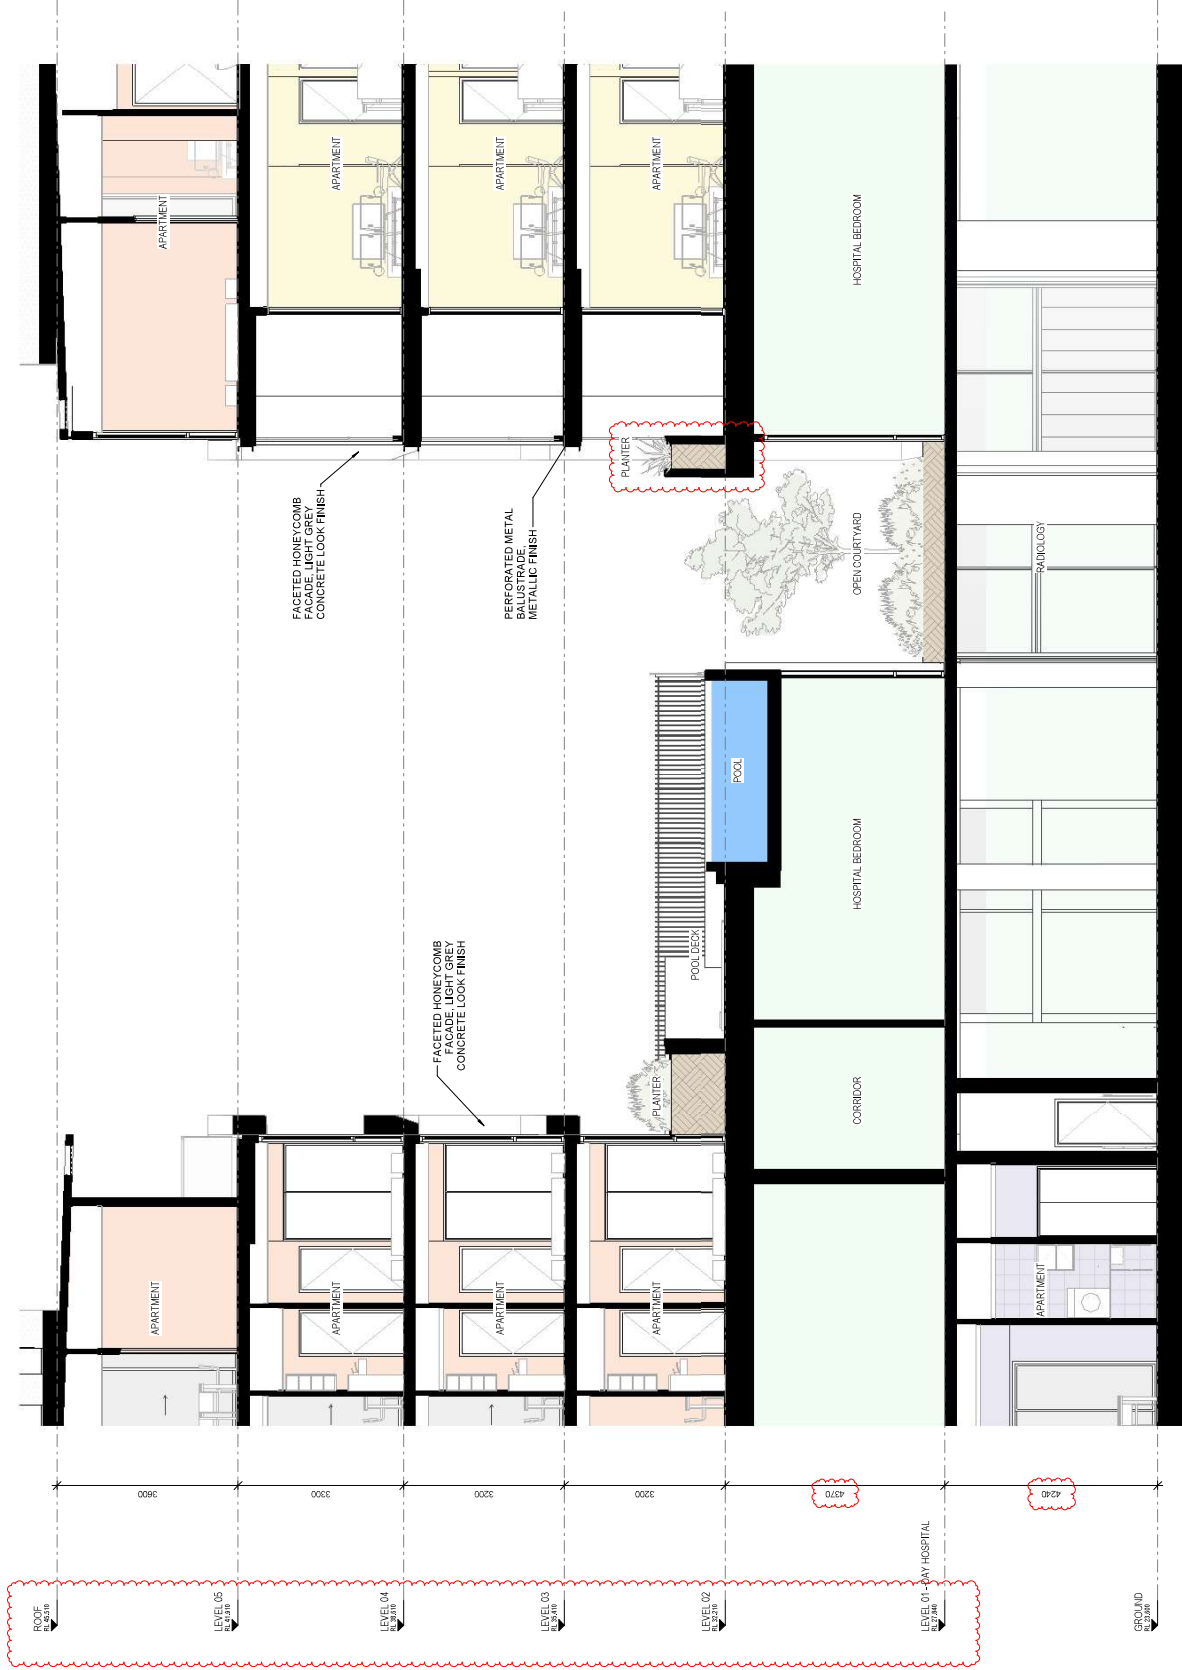

FACETED HONEYCOMB
FACADE, LIGHT GREY
CONCRETE LOOK FINISH

PERFORATED METAL
BALUSTRADE
METALLIC FINISH

FACETED HONEYCOMB
FACADE, LIGHT GREY
CONCRETE LOOK FINISH

LEGEND:

REV	DATE	DESCRIPTION
B	20.08.2025	DA APPLICATION

REVISION:

NOT TO SCALE
This drawing is a preliminary design and is subject to change without notice. It is not to be used for construction or other purposes without the written consent of the architect. The architect shall not be responsible for any errors or omissions in this drawing. The client shall be responsible for obtaining all necessary permits and approvals. The architect shall not be responsible for any structural or engineering issues. The architect shall not be responsible for any environmental or sustainability issues. The architect shall not be responsible for any legal or regulatory issues. The architect shall not be responsible for any other issues. The architect shall not be responsible for any other issues. The architect shall not be responsible for any other issues.



Operational Management Plan

Surgical Centre

No.5 Wunderlich Street
Subiaco

Contents

1.0 Introduction	1
2.0 Location	2
3.0 Proposed Development	3
Overview	3
Business Times	4
Capacity	4
Staff	4
Patients	5
4.0 Parking and Access	6
Car Parking.....	6
Access	7
5.0 Waste.....	9



1.0 Introduction

This Operational Management Plan ('OMP') has been prepared in support of an Application for Development Approval for a Short Stay Surgical Centre at Lot 81 (No.5) Wunderlich Street, Subiaco ('site'). The purpose of the OMP is to document how the Surgical Centre will operate to minimise impacts on the locality.

2.0 Location

The site is situated in the locality of Subiaco with frontage to Hay Street, Roberts Road and Wunderlich Street. The site is within 500 metres walking distance to Subiaco Train Station.

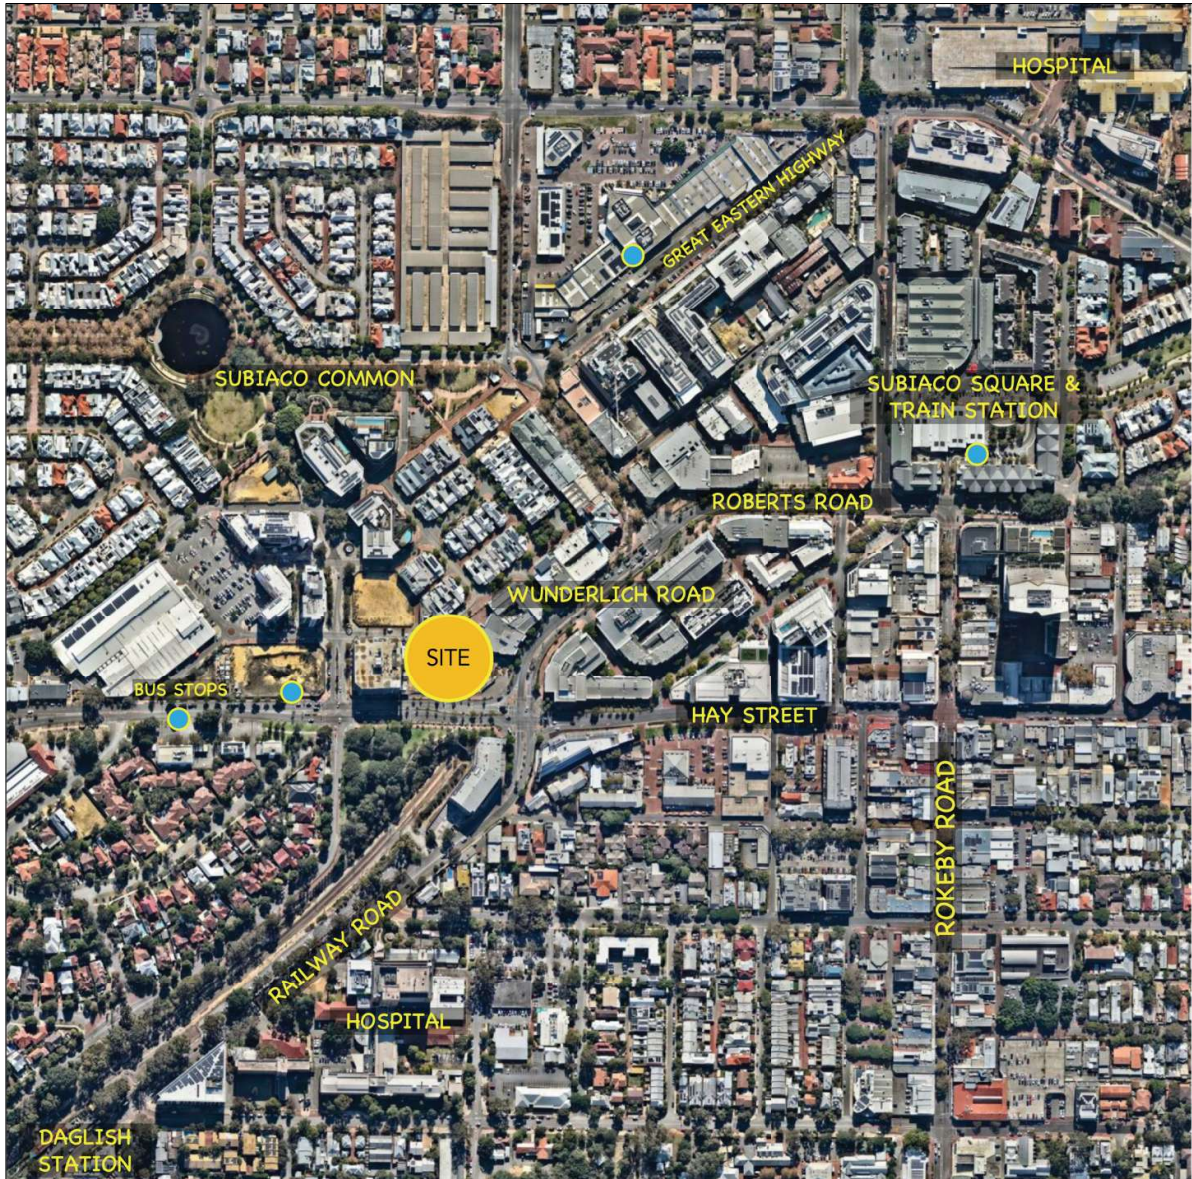


Figure 1: Location of Surgical Centre

3.0 Proposed Development

Overview

The Short Stay Surgical Centre, a private facility strategically located in the heart of Subiaco, is designed to deliver a comprehensive range of essential medical services to the community. The facility will offer elective surgery with both day-only and overnight accommodation.

The centre aims to streamline patient care by reducing travel and consolidating services into one location. This holistic approach minimizes the number of appointments and venues patients need to visit for diagnosis and treatment.

The premises will be purpose-built, considering all aspects of the centre’s operation, including staffing, patient access, parking, visiting hours, and waste management.

The Surgical Centre is for Elective Surgery only and strictly ‘No Emergency’.

The Surgical Centre will occupy the First Floor of an approved mixed-use development, with back-of-house facilities located on the Ground Floor. It is anticipated the Surgical Centre will be supported by health-related services occupying the building’s Ground Floor tenancies, such as Radiology, Physiotherapy and a Pharmacy.



Figure 2: Floor Plan of Surgical Centre

Business Times

Business Days	Monday to Sunday
Surgery Times	Monday to Friday 7.30am to 6.30pm
Patient Arrival	6.30am to 10.30am
Visitor Times	9.00am to 9.00pm
Staff Arrival / Departure	Refer below.

Capacity

Beds	35
Operating Theatres	4
Daily Operations	6 per theatre 24 operations at full capacity
Admissions	Maximum of 24 daily admissions at full capacity
Length of Stay / Discharge	Typically, 50% of patients will be discharged on the same day, with the remaining 50% requiring an overnight stay of up to 3 days. Patients requiring an overnight stay are generally admitted at the start of the week (Monday to Wednesday), ready for discharge prior to the weekend (Wednesday to Friday). The precise number of patients requiring an overnight stay will vary depending on the patient's diagnosis and recovery.

Staff

Operating Theatres		
<ul style="list-style-type: none"> • Consultants • Support 	12 15	3 per theatre - doctor, surgeon, anaesthetist Pre-op, recovery, sterilization, other
Ward	8	Manager and nurses
Administration	4	
Radiologist	1	
Total Staff	40	Assuming full capacity at any one time
Other Consultants	10	In addition to the staff listed above, typically 8 to 10 consulting specialists / doctors / healthcare workers would visit the Surgical Centre on any given day.

The above staffing levels assume the facility will run at 100% capacity, which is unlikely to occur. In practice, the Surgical Centre would aim to run at 85% capacity.

Staff Rostering and Shift TimesMorning Shift (6.30am to 2.30pm)

The peak operating time of the Surgical Centre occurs in the morning. Typically, up to 10 staff will arrive at the start of the morning shift (6.30am) ready to receive the first patients for the day. Staff numbers will steadily increase during the morning with all rostered staff on-site by 9am.

Afternoon Shift (2pm to 10pm)

During the afternoon shift, the number of staff at the Surgical Centre will decrease to approximately 20, as surgeries finish and patients are discharged. Administrative staff will depart by 8pm latest, further reducing the number of staff at the premises in the evening.

Night Shift (9.30pm to 7am)

A maximum of 5 staff would typically be rostered to work during the night, depending on the number of patients staying overnight in the ward.

Patients

Patients will arrive from 6.30am for surgery. Patient admission times are staggered, with up to 2 patients scheduled to arrive every 30 minutes. The pre-operation admission process typically takes up to 1 hour before surgery commences.

Visiting Times

Visiting times will be limited to 9am to 9pm each day and strictly enforced.

4.0 Parking and Access

Car Parking

30 car bays in the upper level of the Basement will be allocated to the Surgical Centre. The proposed allocation of car bays is depicted below.

Staff Parking

19 car bays will be set aside for staff parking (theatre consultants, specialists, managers).

Visitor Parking

11 car bays will be set aside for visitors, including patient set down / pick up, and people visiting overnight patients. Four (4) of these car bays will be set aside for short-term patient set down / pick up (maximum 1 hour parking) with the remaining visitor bays available for longer-term parking (2-3 hours). The patient set down / pick up bays will be available to general visitors outside of the patient admission / discharge times. The patient set down / pick up bays are positioned near the lift leading to the Surgical Centre.



Figure 3: Surgical Centre Car Bays

Access

Vehicle Access

Vehicle access to / from the Basement will be obtained from Wunderlich Street via the approved driveway of the under-construction building to the west, as shown below.

Prior to admission, patients will be provided with instructions to access the car park and will be given a code to operate the security gate at the Basement entry point. This will reduce reliance on street parking in the locality and avoid delays at the time of arrival.

Signage will be installed in the car park to direct visitors to the Surgical centre car parking area. Internal security gates will prevent visitors from being able to access the residential parking areas.



Figure 4: Vehicle Access to Surgical Centre Car Bays

Pedestrian Access

Pedestrian access to the Surgical Centre will be obtained from the Ground Floor commercial lobby off Hay Street, which is connected to the First Floor by a lift and stairs.

Pedestrian access from the Basement to the Surgical Centre will be provided by the lobby lift and stairs, with a second lift providing access for staff to the Ground Floor back-of-house facilities and the First Floor Surgical Centre.

Ambulance Access

The Surgical Centre will be for Elective Surgery only and the vast majority of patients will arrive by private car. No Emergency procedures will be available and for this reason there is no requirement to provide any on-site queuing facilities for Ambulances.

By law, the Surgical Centre is required to make provision for an Ambulance to park in close proximity in the unlikely event a patient needs to be transferred to another hospital. For this reason, it is proposed that the pre-approved Loading Bay on Wunderlich Street be signposted for Ambulance parking in addition to commercial vehicle parking. The back-of-house service corridor on the Ground Floor exits to Wunderlich Street in close proximity to the Loading Bay, with a lift providing access to the Surgical Centre in the event of a patient transfer by Ambulance.

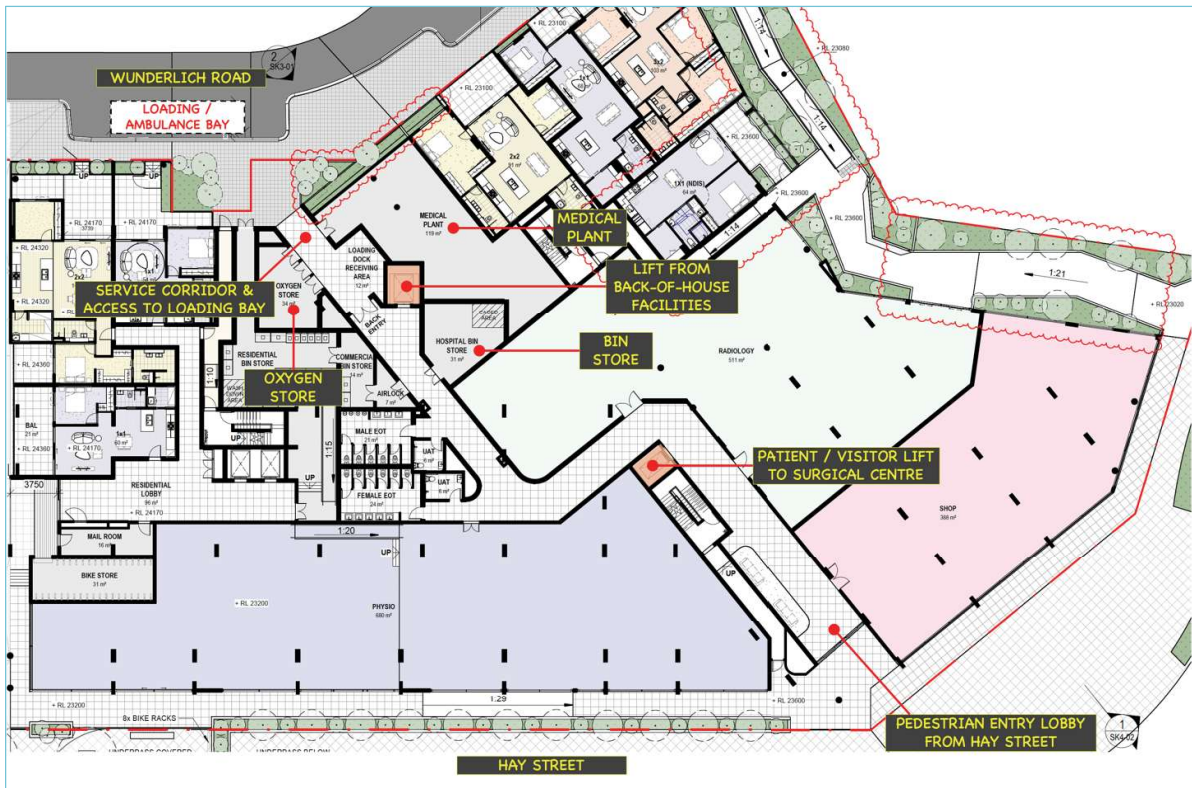


Figure 5: Ground Floor Access and Back-of-House Facilities

Public Transport

The site is well serviced by public transport (bus services).

Route	Description	Location of Stops
28	Perth Busport – Claremont Train Station	Hay Street Stop No.16936 (<150 metres) Stop No.16925 (<250 metres)
97	Subiaco Train Station – QEII Medical Centre / UWA	Stop No.17520 Subiaco Station (500 metres)
Train	Fremantle to Midland Line Fremantle to Forrestfield Line	Subiaco Station (500 metres) Daglish Station (500 metres)



5.0 Waste

The Surgical Centre is provided with a separate and secure waste storage facility on the Ground Floor, including medical waste (see Figure 5 above). The waste store is accessed from the service corridor and located in close proximity to the Loading Bay on Wunderlich Street.

Waste Contractor

All waste from the Surgical Centre will be collected by Daniels Health: a medical / health services waste contractor.

Collection Point

Daniels Health will utilise a standard sized bin truck and park in the designated (approved) loading bay on Wunderlich Street. The waste contractor will access the bin store via the service entry door on Wunderlich Street.

Collection Frequency & Bin Capacity

General Waste

- 2 x 1,100 litre bins
- 2 collections per week.

Recyclable Waste

- 2 x 1,100 litre bins.
- 1 x collection per week.

Medical Waste

- 4 x 64 litre bins.
- 2 x collection per week.
- 2 x S14 bins.
- 2 x S22 bins.
- 2 x S32 bins.
- 1 x collection per week.

Hazardous Waste

Not applicable.

Collection Time

All waste from the Surgical Centre will be collected between 7am to 7pm Monday to Friday.

Bin Store

The secure bin store on the Ground Floor has sufficient capacity to accommodate the bins required to meet the waste generation needs of the Hospital.

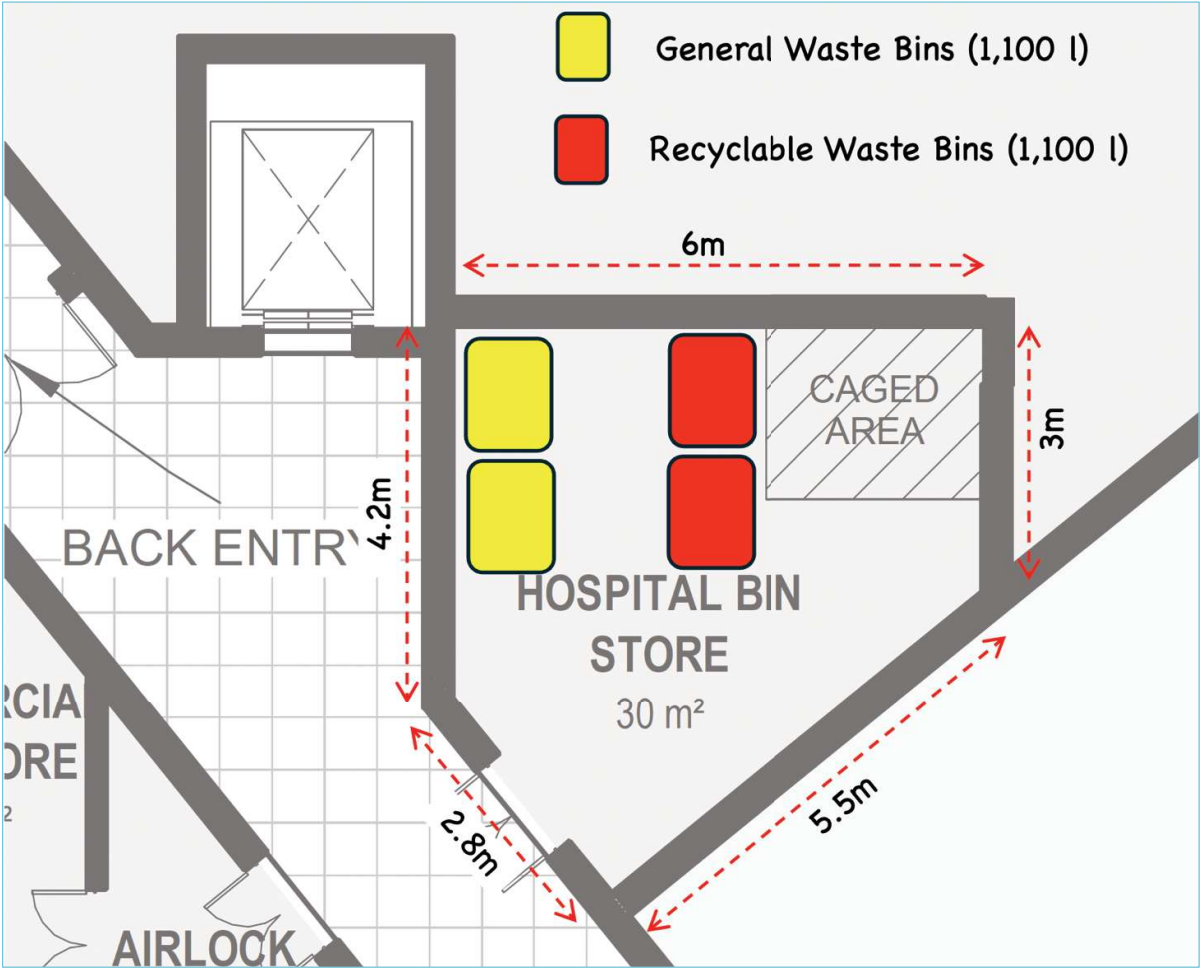


Figure 6: Bin Store

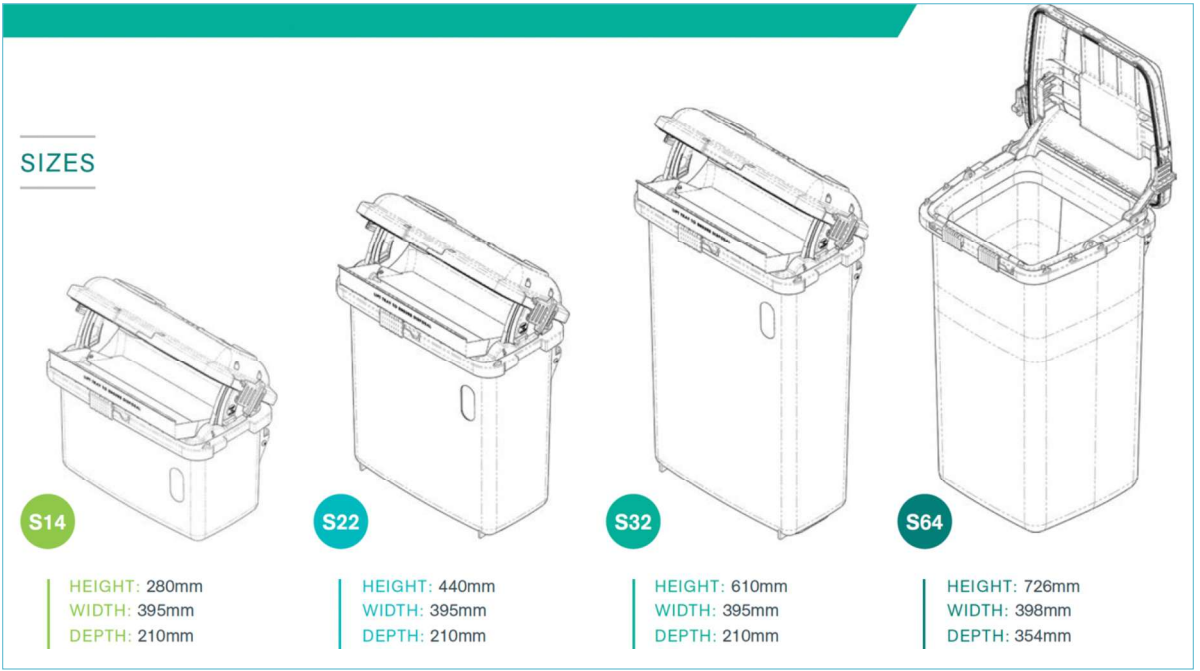


Figure 7: Dimensions of Medical Waste Bins

